

SURVEYED	SWX	14.07.2015	APPROVED	DATE
DESIGNED				
DRAWN	LK	14.07.2015		
CHECKED				
APPROVED				
REVISION	CHANGES		CHECKED	DATE
0	ORIGINAL ISSUE		MC	15.07.15
1	LOT BOUNDARY UPDATED		MC	10.09.15

NOTES:

BEARING AND COORDINATE DATUM IS GEODETIC 2000
ORIGIN IS 16 MT. EDEN 800 000 mN, 400 000 mE
PROJECTION IS TRANSVERSE MERCATOR TO OBTAIN
PROJECTION DISTANCES MULTIPLY BY 0.9999

LEVELS ARE IN TERMS OF LANDS AND SURVEY
DATUM (MSL) AUCKLAND 1946

SURVEY EQUIPMENT USED:

INSTRUMENT: TRIMBLE ROBOTIC S8 1"
GPS: TRIMBLE R6/R8 SYSTEMS
PRECISE LEVELLING: TRIMBLE Dini Series 0.3mm DIGITAL
VERTICAL PLUMMIT: FOIF DZJ2 LASER PLUMMIT

COPYRIGHT:

This document and the copyright in this document remain the
property of SURVEY WORX. The contents of this document
may not be reproduced either in whole or in part by any means
whatsoever without the prior written consent of SURVEY WORX.

SURVEY WORX+
CONSTRUCTION & LAND SURVEYORS

mobile +64 021 824 084
office +64 09 948 6491
www.surveymorx.co.nz

6 Aranui Road, Sylvia Park, Auckland, NZ



REGISTERED
PROFESSIONAL
SURVEYOR



MEMBERS OF:
NZIS
New Zealand
Institute of Surveyors
Te Kaitiaki o Te Kaitiaki

CLIENT

SPINNAKER BAY LID

PROJECT

SOLWAY
285 ARA - KOTINGA

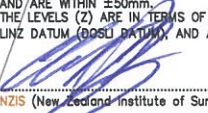
TITLE

ELECTRICAL
ASBUILT STAGE 1

SCALE	1:1000 (A1)	1:2000 (A3)
DRAWING No	55-932-605-14	SHEET 1 of 2
REVISION		1

SURVEY WORX+
CONSTRUCTION & LAND SURVEYORS

I, Clinton James Healy, LAND SURVEYOR OF
AUCKLAND, NZ, HEREBY CERTIFY THAT THIS AS-BUILT PLAN
AND THE INFORMATION PROVIDED HAS BEEN FIELD SURVEYED
BY SURVEY WORX AND IS CORRECT.
THE COORDINATES (X, Y) ARE IN TERMS OF NZTM ON NZGD(2000),
AND ARE WITHIN ±50mm.
THE LEVELS (Z) ARE IN TERMS OF THE AUCKLAND 1946 (MSL)
LINZ DATUM (1946 DATUM), AND ARE WITHIN ± 25mm.


NZIS (New Zealand Institute of Surveyors)
Dated this 18th day of June 2016

PLOT DATE: 6/16/2016 3:40 p.m.

